


****CREATE ALL ELEVATIONS ,MILLWORKS & DETAILS
FOR MEETING ROOM02**

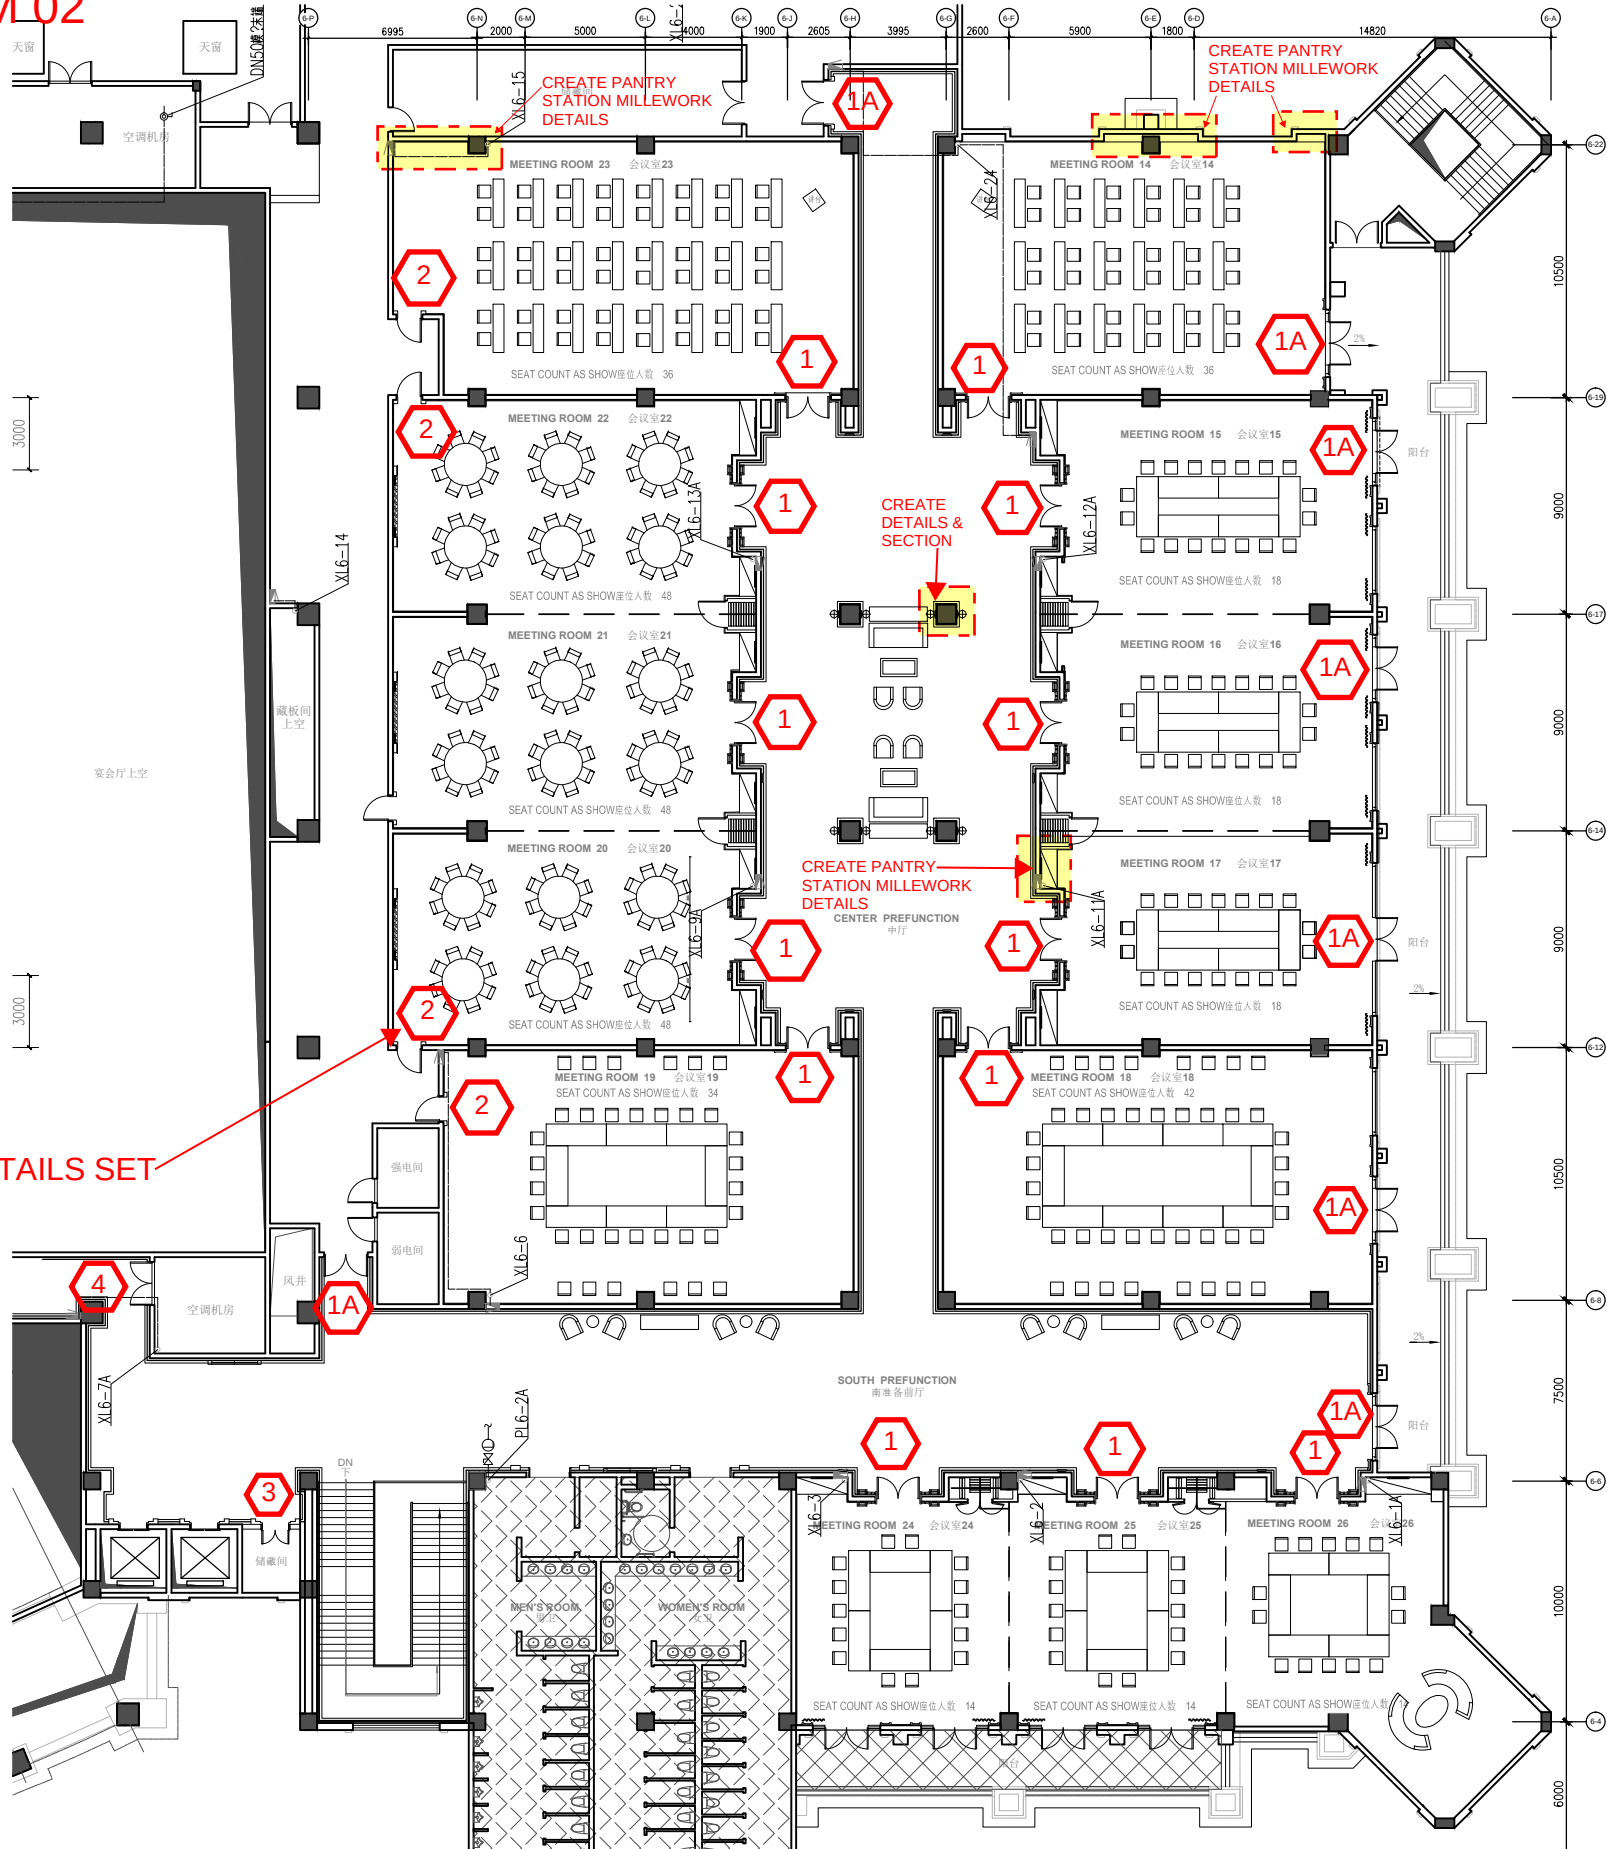

****CREATE ALL DOOR DETAILS SET**

1 五楼会议室平面家具布置图 MEETING ROOMS FURNITURE PLAN - LEVEL 5
1: 100

WATG

strategy | planning | architecture | interiors
Irvine | CA | 949 574 8500 watg.com

pre-final design development | 30 APRIL 2012

no. date issue
issues | revisions

key plan


Hengqinwan Hotel
横琴湾酒店
Zhuhai City, China

MEETING ROOMS
FURNITURE PLAN - LEVEL 3
三层家具布置图

sheet title
project no. 094089 date 04/30/2012

checked by: -
drawn by: -

component
I-8.5.01
sheet no.

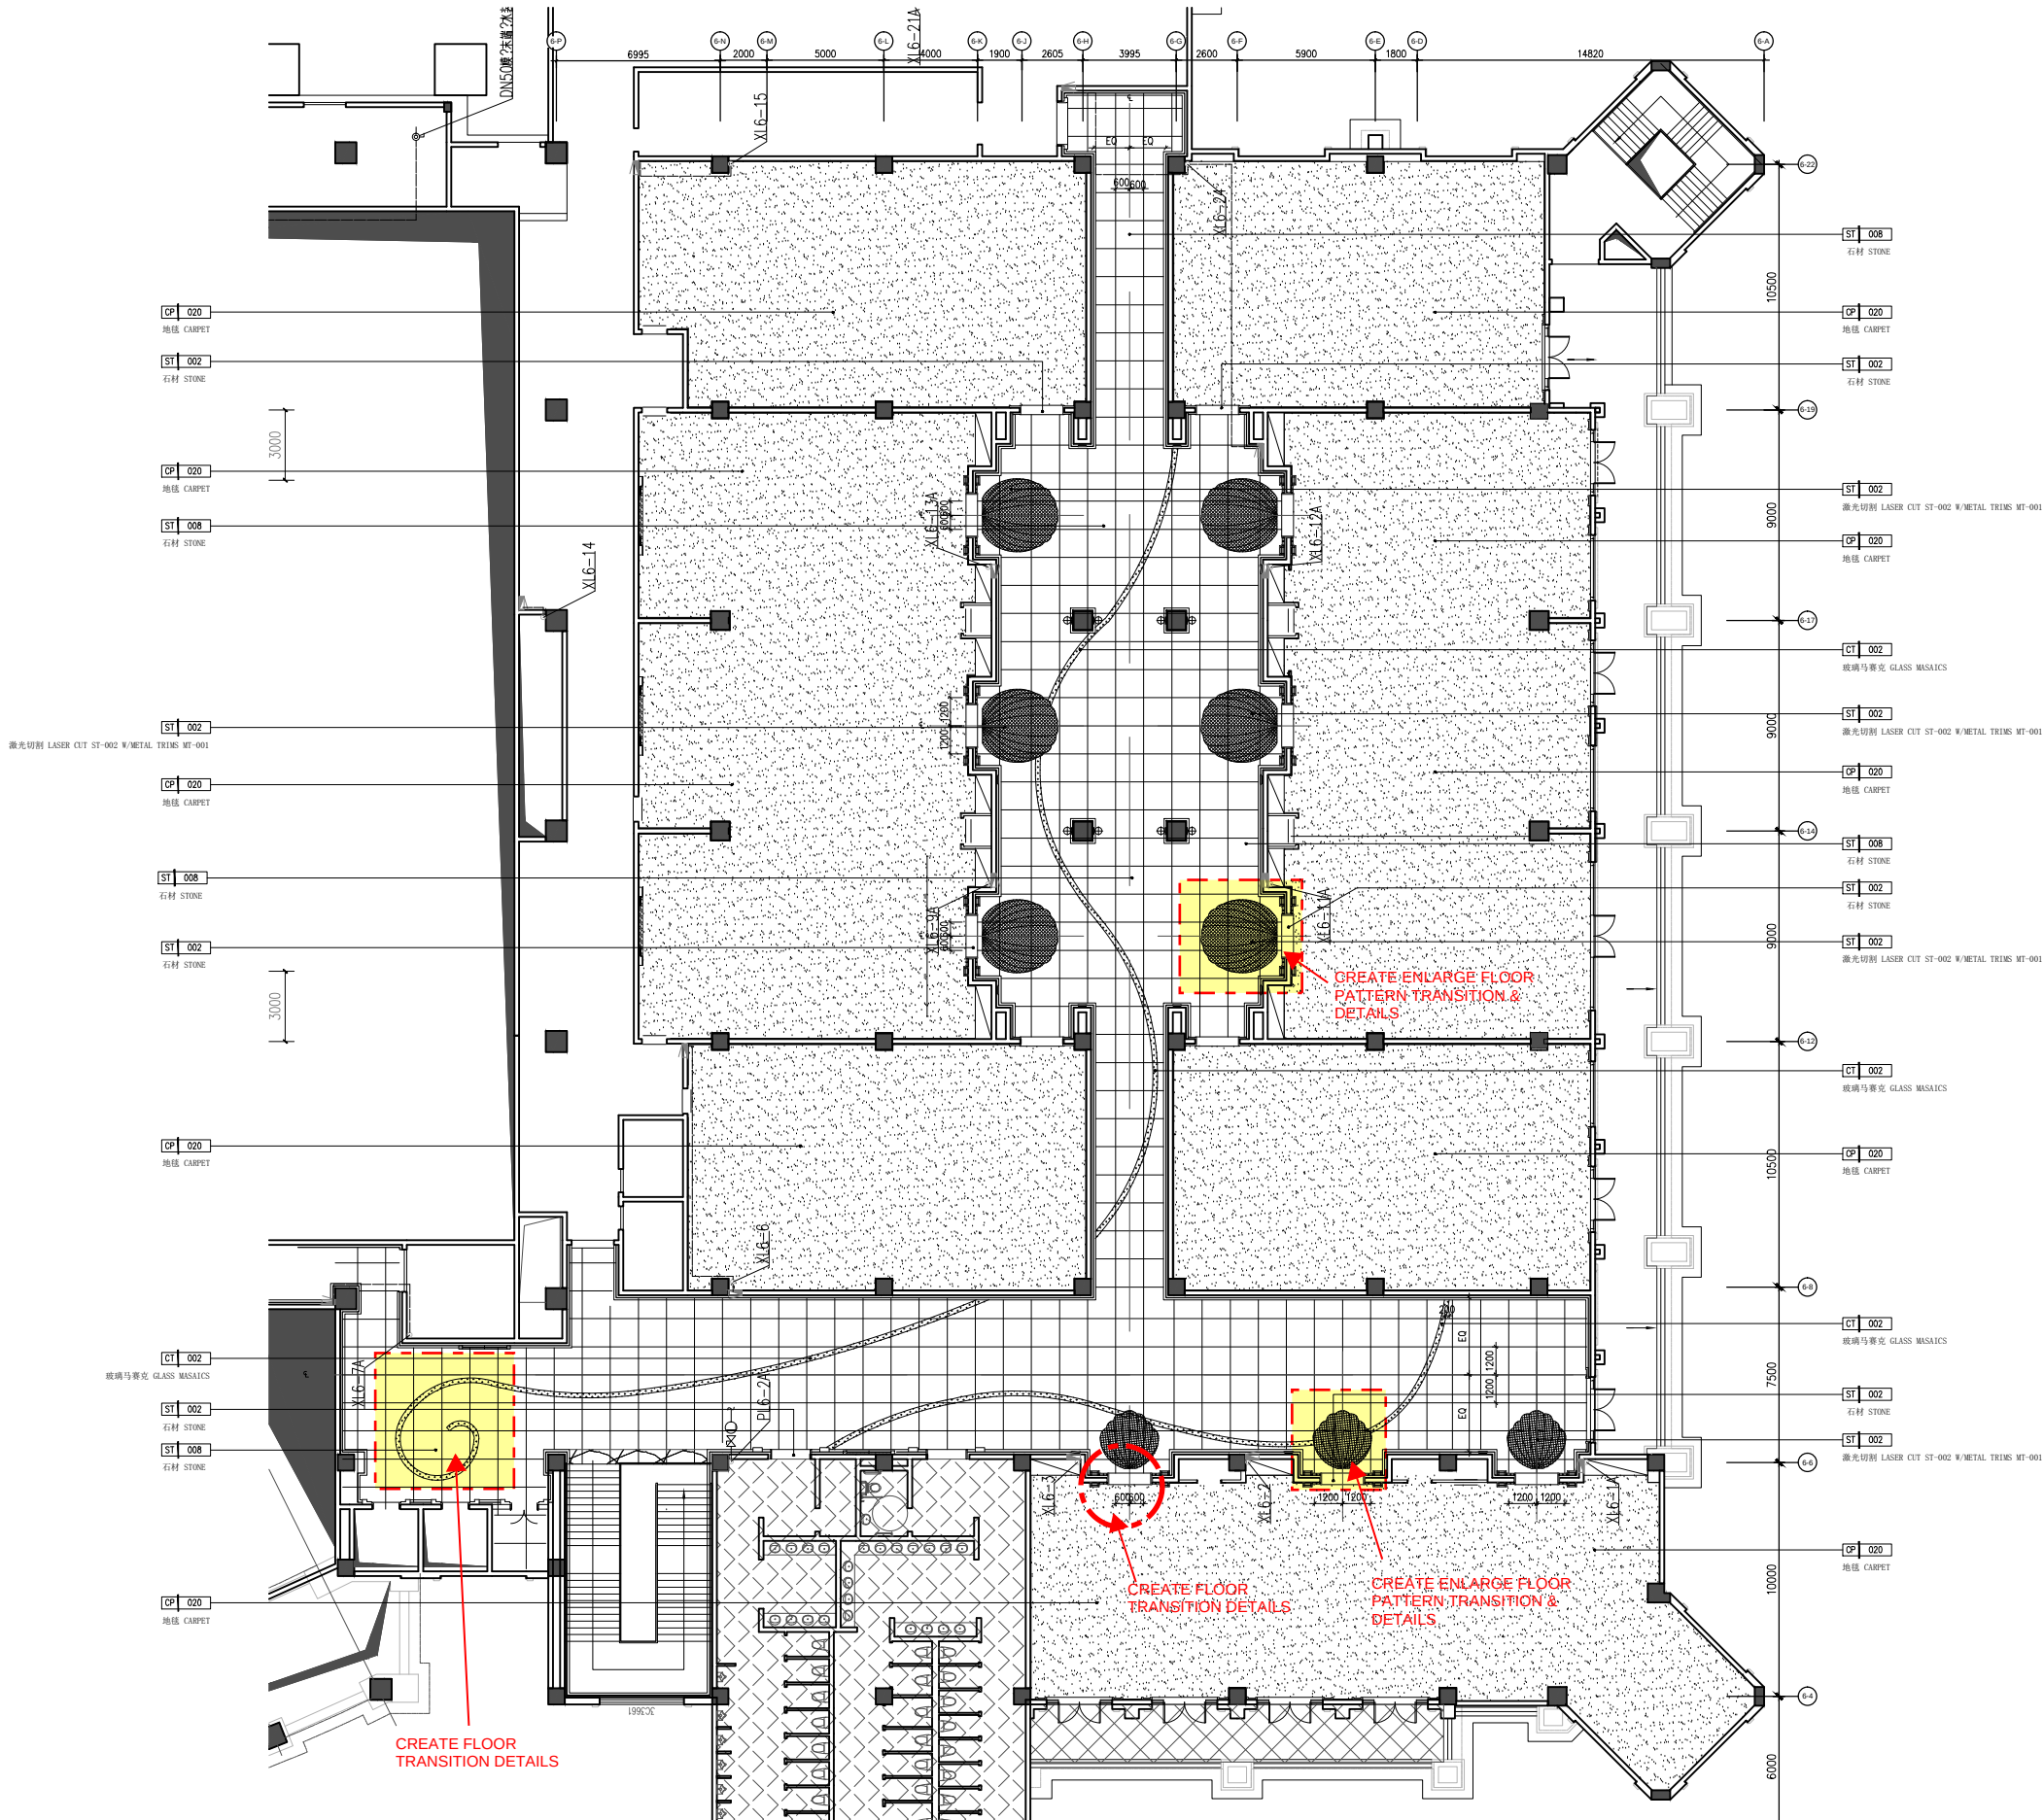

2 五楼会议室地坪布置图 MEETING ROOMS FLOOR COVERING PLAN - LEVEL 5
1 : 100

pre-final design development | 30 APRIL 2012

no. date issue
issues | revisions

key plan


Hengqinwan Hotel
横琴湾酒店
Zhuhai City, China

MEETING ROOMS
FURNITURE PLAN - LEVEL 3
三层家具布置图

project no. 094089 date 04/30/2012
checked by: -
drawn by: -

component

I-8.5.02
sheet no.

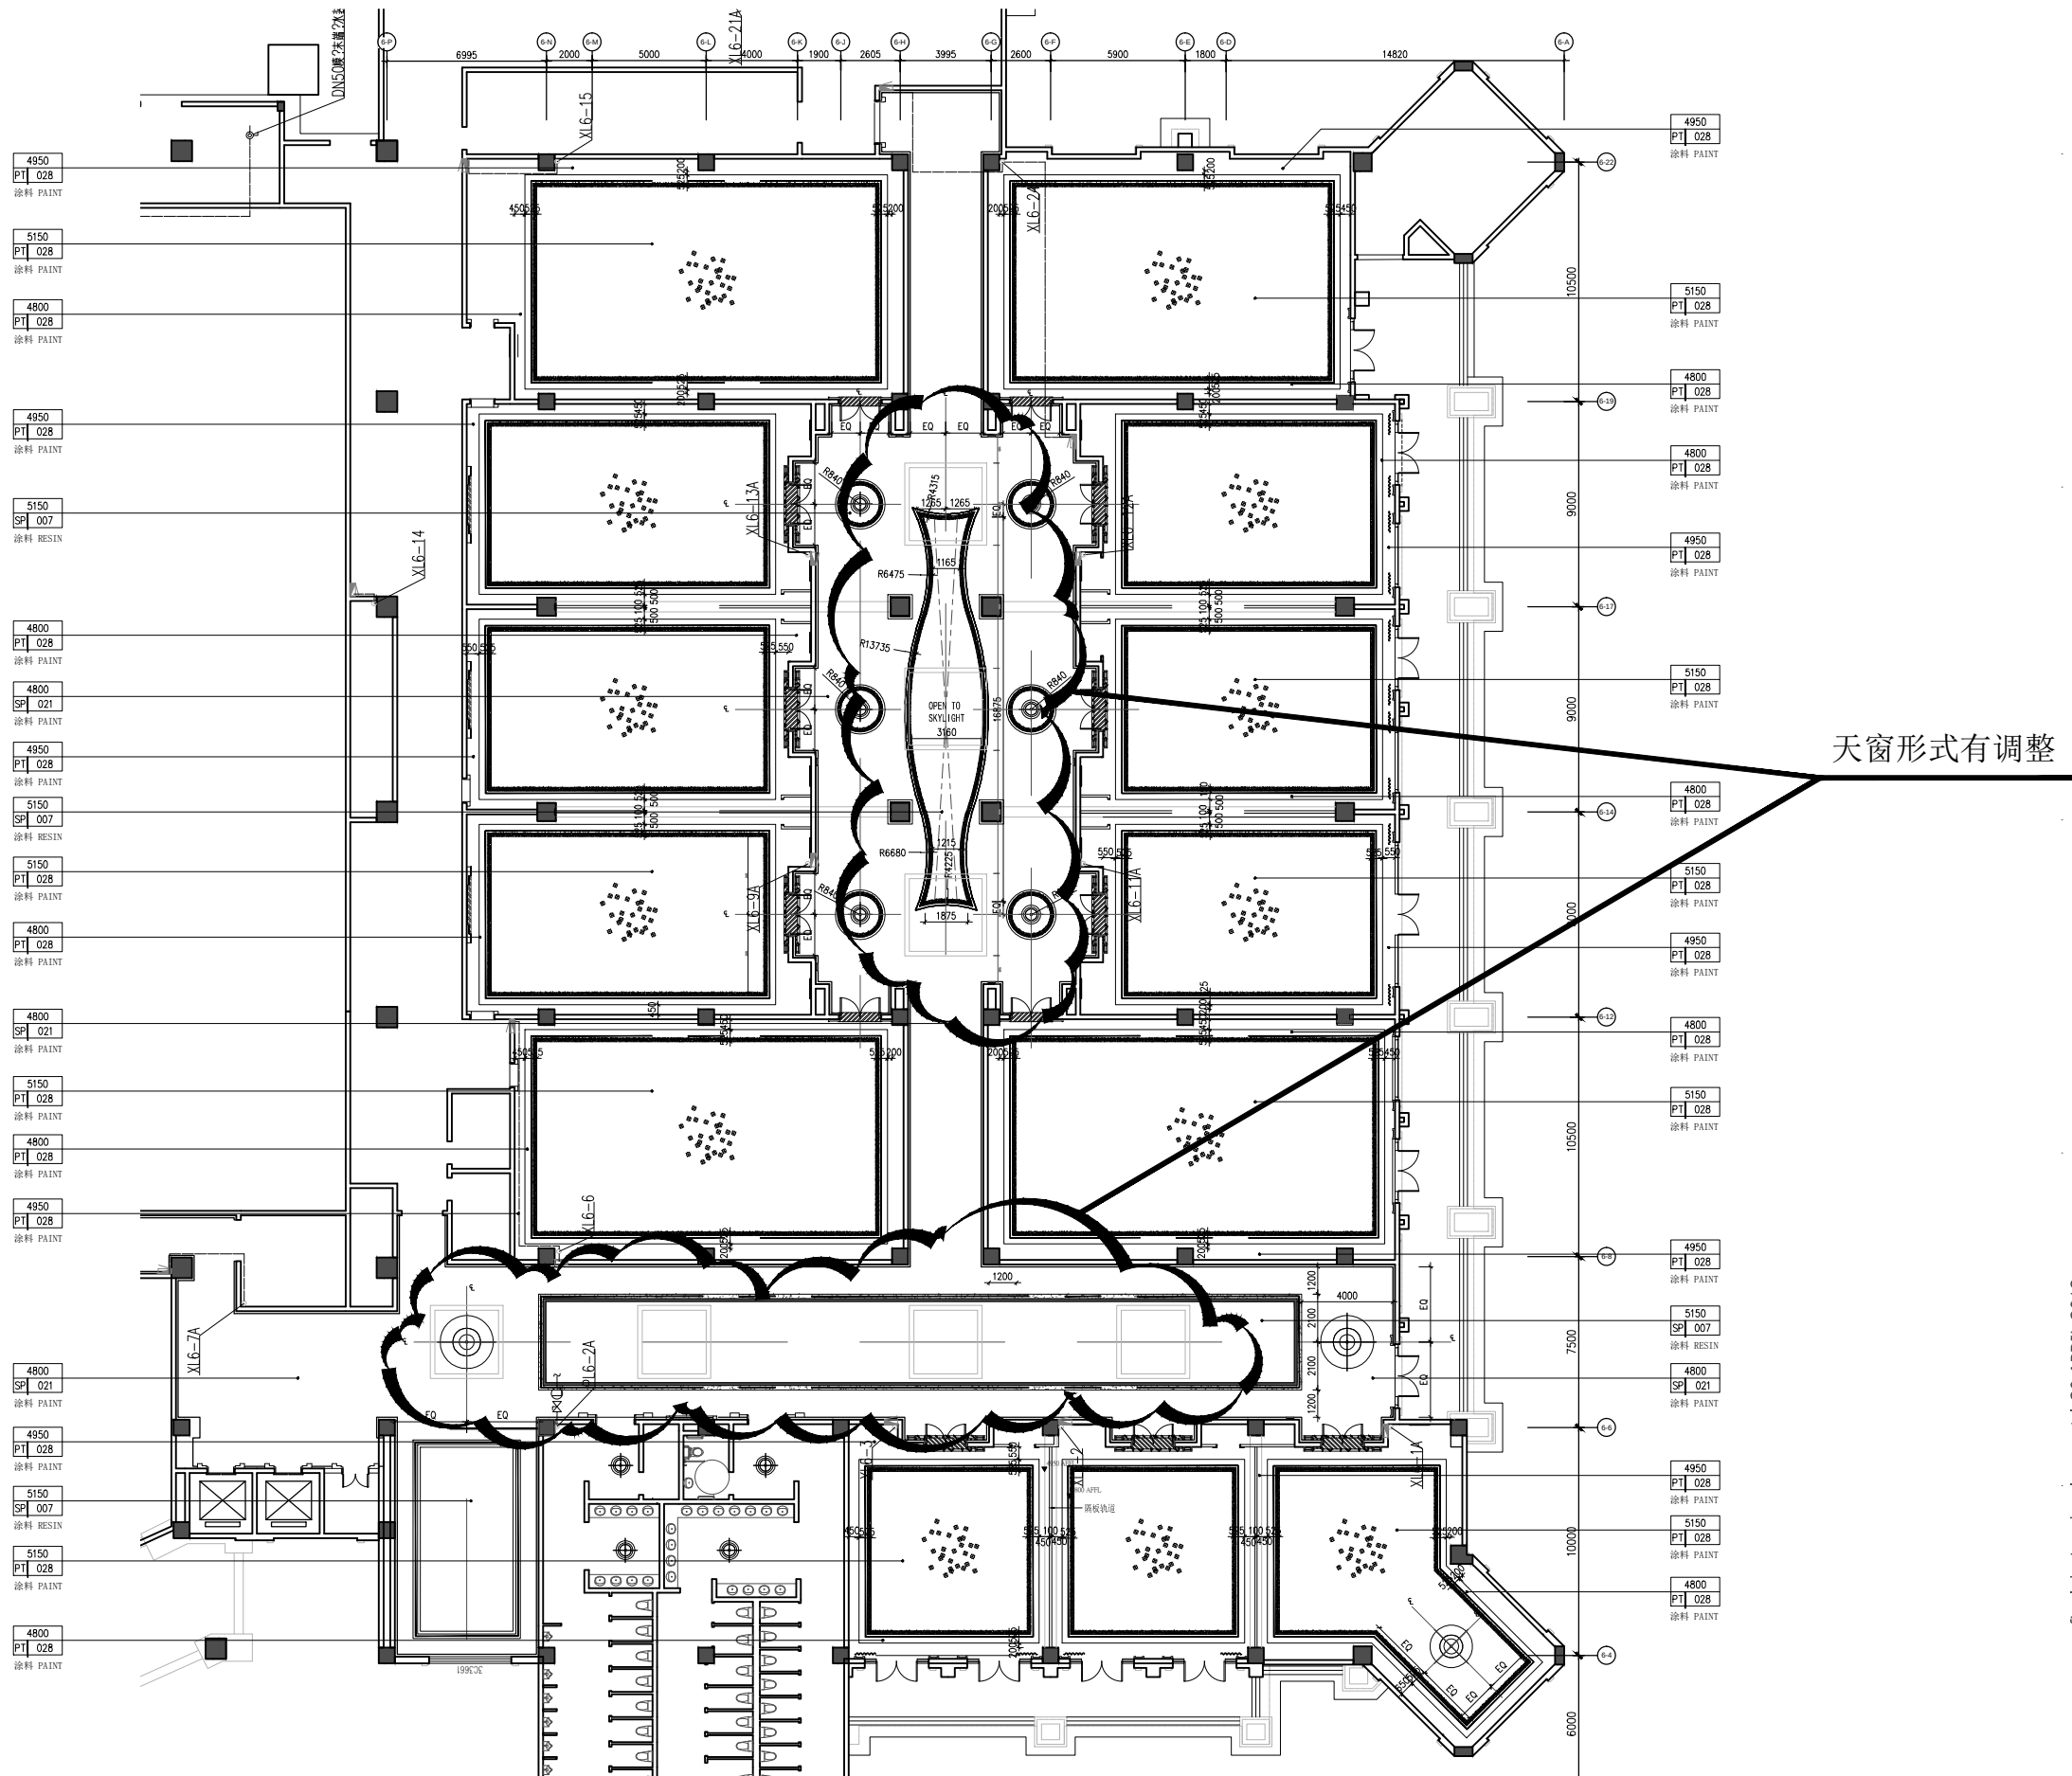

3 五楼会议室顶面布置图 MEETING ROOMS REFLECTED CEILING PLAN - LEVEL 5
1 : 100

pre-final design development | 30 APRIL 2012

no. date issue
issues | revisions

key plan

Hengqinwan Hotel
横琴湾酒店
Zhuhai City, China

MEETING ROOMS
FURNITURE PLAN - LEVEL 3
三层家具布置图

sheet title

project no. 094089 date 04/30/2012

checked by: -
drawn by: -

#

component

I-8.5.03

sheet no.

pre-final design development | 30 APRIL 2012

no. date issue
issues | revisions

key plan

Hengqinwan Hotel
横琴湾酒店
Zhuhai City, China


MEETING ROOMS
FURNITURE PLAN - LEVEL 3
三层家具布置图

sheet title
project no. 094089 date 04/30/2012

checked by: -
drawn by: -

#

sheet no.
I-8.5.04

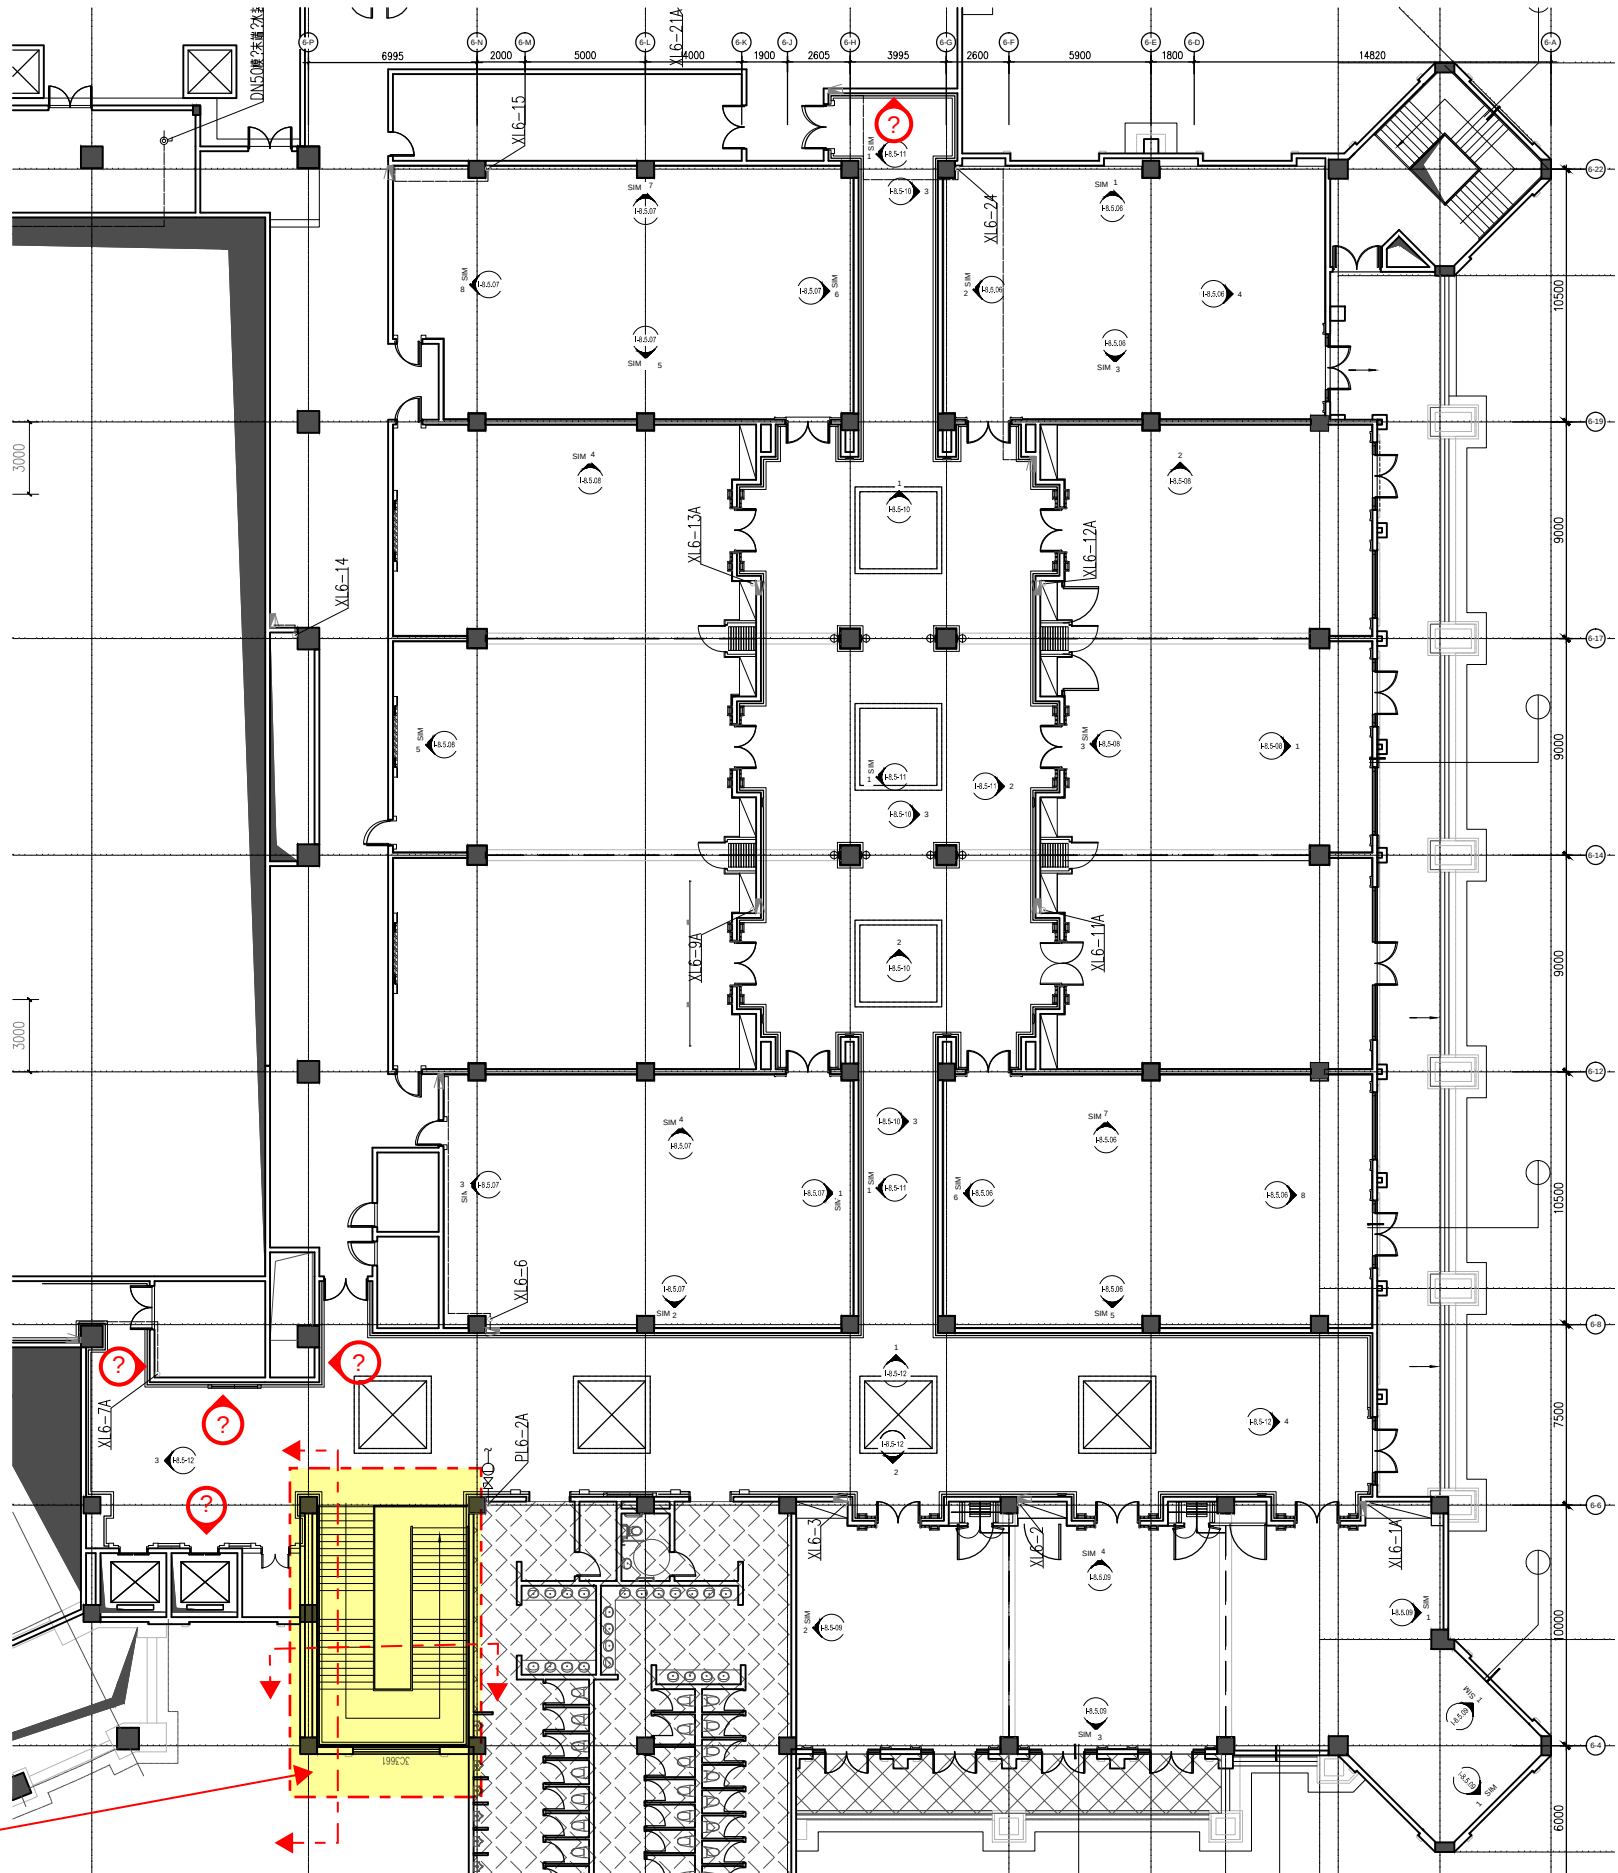

6 五楼会议室立面索引图 MEETING ROOMS REFLECTED CEILING PLAN - LEVEL 5
1: 100

CREATE ENLARGE STAIR DETAILS & SECTIONS